



REVISIONS	NUMBER	DATE	DESCRIPTION


Indian Creek Reserve

Omaha, NE

FSE # 002-001-19

October 22, 2019

Sanitary Service As-Built

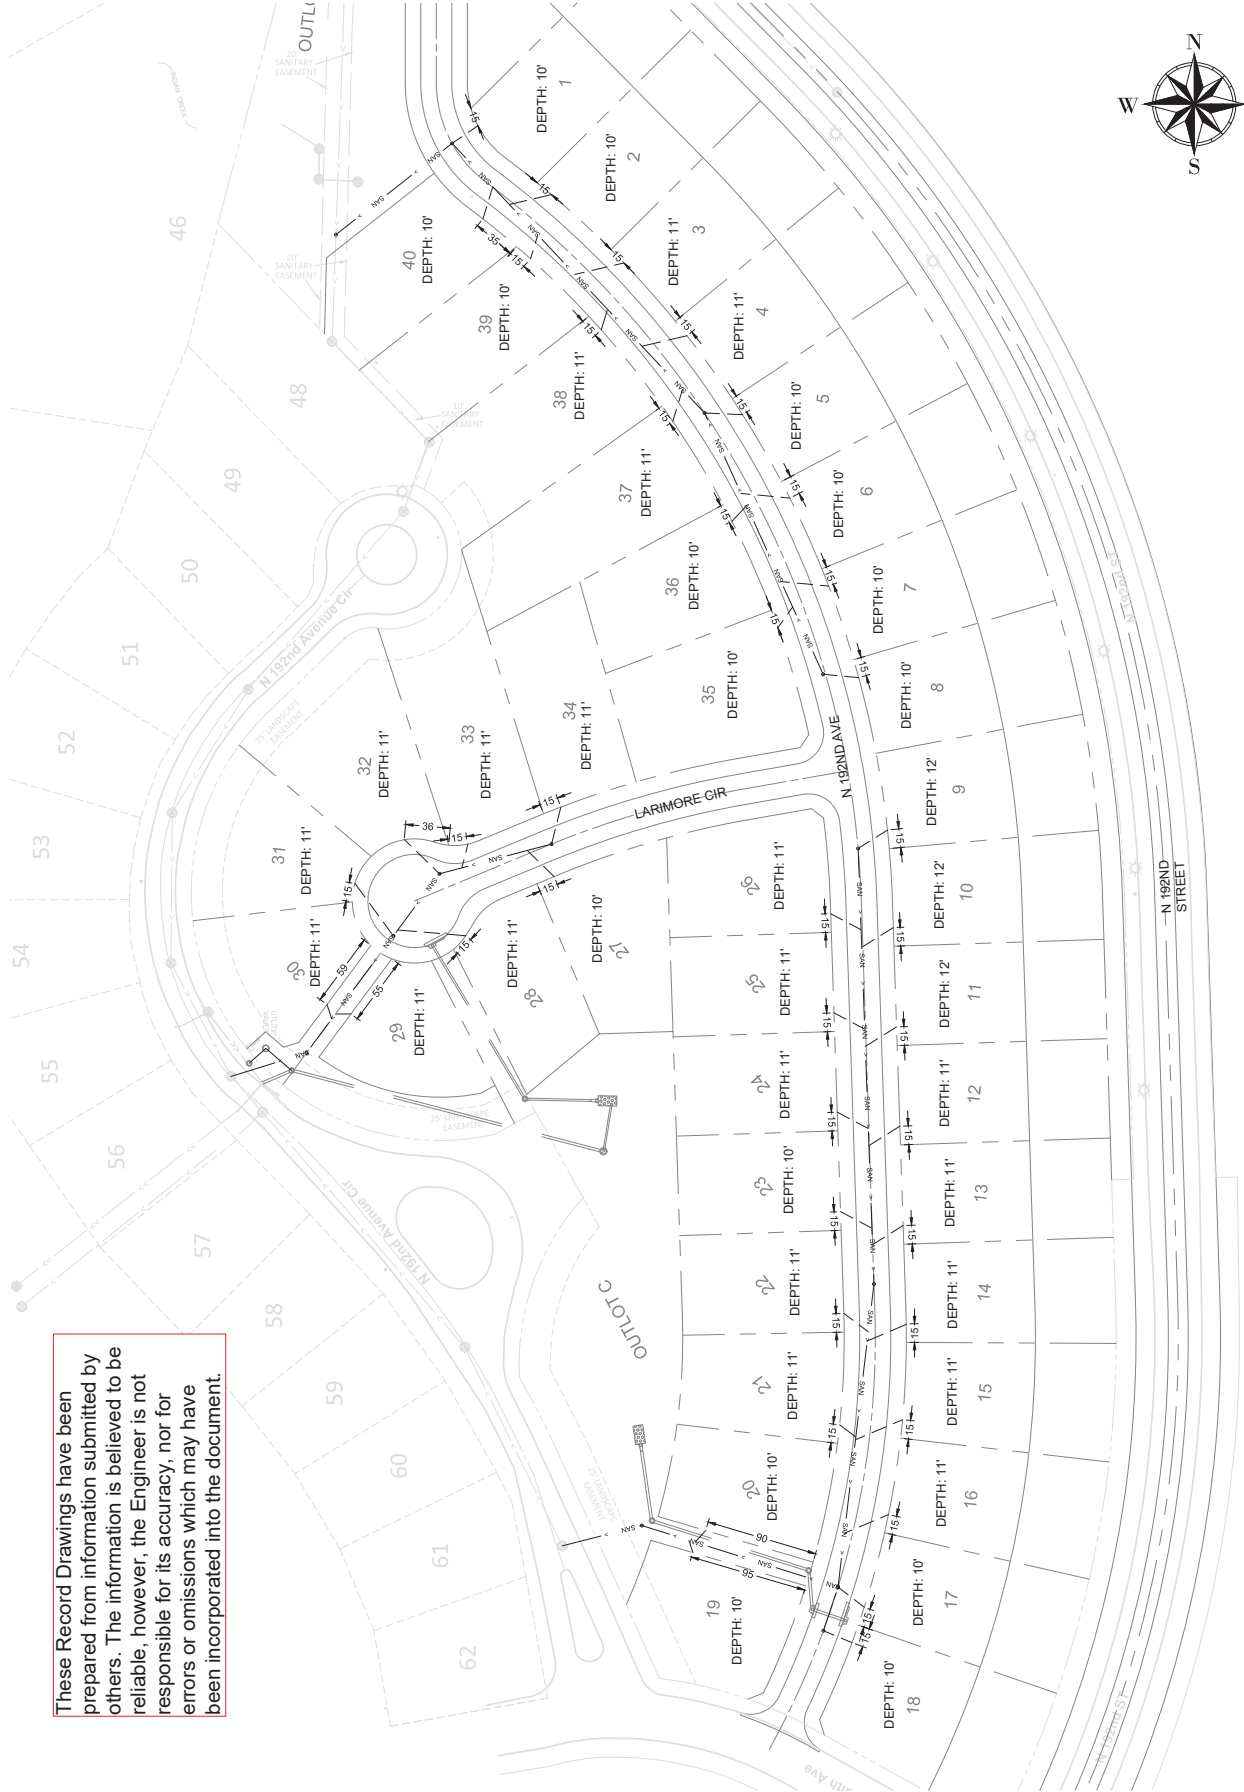

These Record Drawings have been prepared from information submitted by others. The information is believed to be reliable, however, the Engineer is not responsible for its accuracy, nor for errors or omissions which may have been incorporated into the document.